

ARCHITECT
KIERANTIMBERLAKE ASSOCIATES LLP
 420 NORTH 20TH STREET
 PHILADELPHIA, PA 19130
 PHONE: 215-922-6600
 FAX: 215-922-4680
 EMAIL: kta@kierantimberlake.com

OWNER'S REPRESENTATIVE
JFW PROJECT MANAGEMENT
 17650 Club House Road Suite 203
 Montgomery Village, MD 20886
 PHONE: 301-330-3220
 FAX: 301-330-3487

STRUCTURAL ENGINEER
CVM ENGINEERS
 65 OLD ENGLE SCHOOL ROAD
 WAYNE, PA 19087
 PHONE: 610-989-3800
 FAX: 610-989-3677

MEP ENGINEER
BRUCE BROOKS & ASSOCIATES
 2209 Chestnut St
 Philadelphia, PA 19130
 PHONE: 215-569-0400
 FAX: 215-569-2664

LANDSCAPE ARCHITECT
ANDROPOGON ASSOCIATES, LTD
 10 SHURLS LANE
 PHILADELPHIA, PA 19127
 PHONE: 215-484-0700
 FAX: 215-483-9200

CIVIL ENGINEER
VKA, INC.
 8180 Greensboro Drive Suite 200
 McLean, VA 22102
 PHONE: 703-442-7800
 FAX: 703-761-2787

LIGHTING CONSULTANT
SEAN O'CONNOR ASSOCIATES
 211 NORTH 13TH STREET
 PHILADELPHIA, PA 19107
 PHONE: 215-988-9200
 FAX: 215-988-9008

LIGHTING CONSULTANT
BENYA LIGHTING DESIGN
 17937 SW MCEWAN AVENUE, SUITE 2208
 TIGARD, OR 97224
 PHONE: 503-718-5483
 FAX: 503-718-5485

WASTEWATER CONSULTANT
NATURAL SYSTEMS INTERNATIONAL
 3600 CERRILLOS ROAD, SUITE 1102
 SANTEE, CA 95070
 PHONE: 505-988-7453
 FAX: 505-988-3720



SIDWELL FRIENDS SCHOOL
 BETHESDA, MARYLAND
 WASHINGTON, DC


MIDDLE SCHOOL

KTA PROJECT NO. 694
LEVEL 1 FLOOR PLAN

SCALE: 1/8" = 1'-0"
 DRAWN BY: PW, CB
 CHECKED BY: SR, AF
 CAD FILE: 694_A2.1.DWG
 DATE: 01 JUNE 2007

REVISIONS	DATE	DESCRIPTION
1	18 AUG 05	RFP#2
2	29 AUG 05	RFP#2A
3	30 AUG 05	RFP#5A
4	30 AUG 05	RFP#6
5	07 SEP 05	RFP#7
6	14 SEP 05	ASFP REVISED
7	05 OCT 05	PROS. BD RFI 1-76 INCORP.
8	05 OCT 05	RFP#8
9	05 OCT 05	ISSUED FOR CONSTRUCTION

LEGEND	FLOOR PLAN GENERAL NOTES
NEW WALL	1. AT DIMENSING PARTITIONS, DIMENSION STRING TO CENTER LINE OF PARTITION
CONC.	2. RP INDICATES STARTING POINT FOR PANEL DIMENSIONS
OMT	3. SEE A8.1 FOR PARTITION TYPES
BRCK	4. GRAPHICS OF EXTERIOR WALL UPDATED

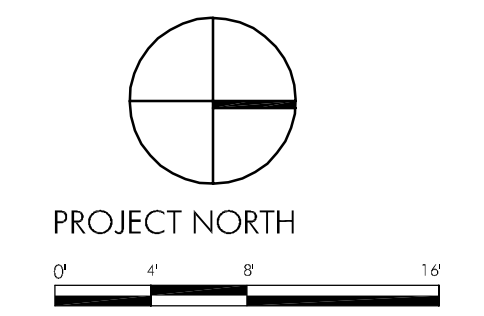

1
 A2.1
 LEVEL 1 FLOOR PLAN
 1/8" = 1'-0"

A2.1
 RECORD SET